



# Water Distribution System

**Legend**



- 14 Legal Lot Number
- (8) Lot Number
- 4" AC (Asbestos Cement) Waterline
- ⊗ Cut-Off Valve
- Thrust Block
- ⊗ Water Valve
- ⊗ Water Connection
- ⊗ 4 1/2 inch Hydrant

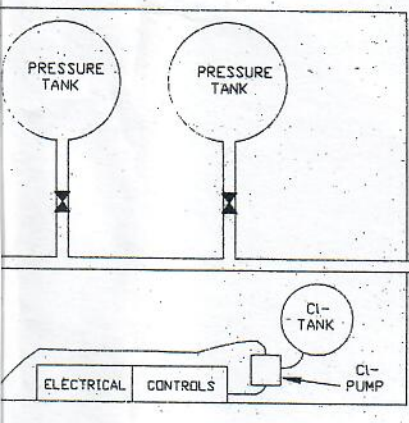

Approximate Scale  
1 in = 2 ft.

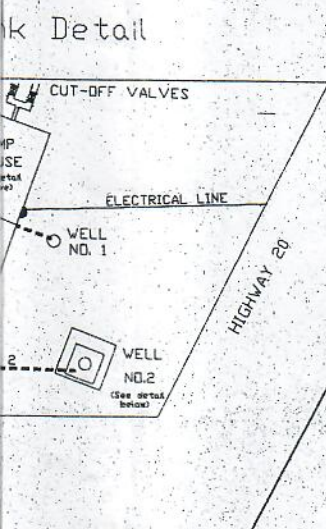

BLOCK NO. 3  
DIV. NO. 2  
BLOCK NO. 4

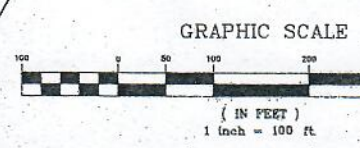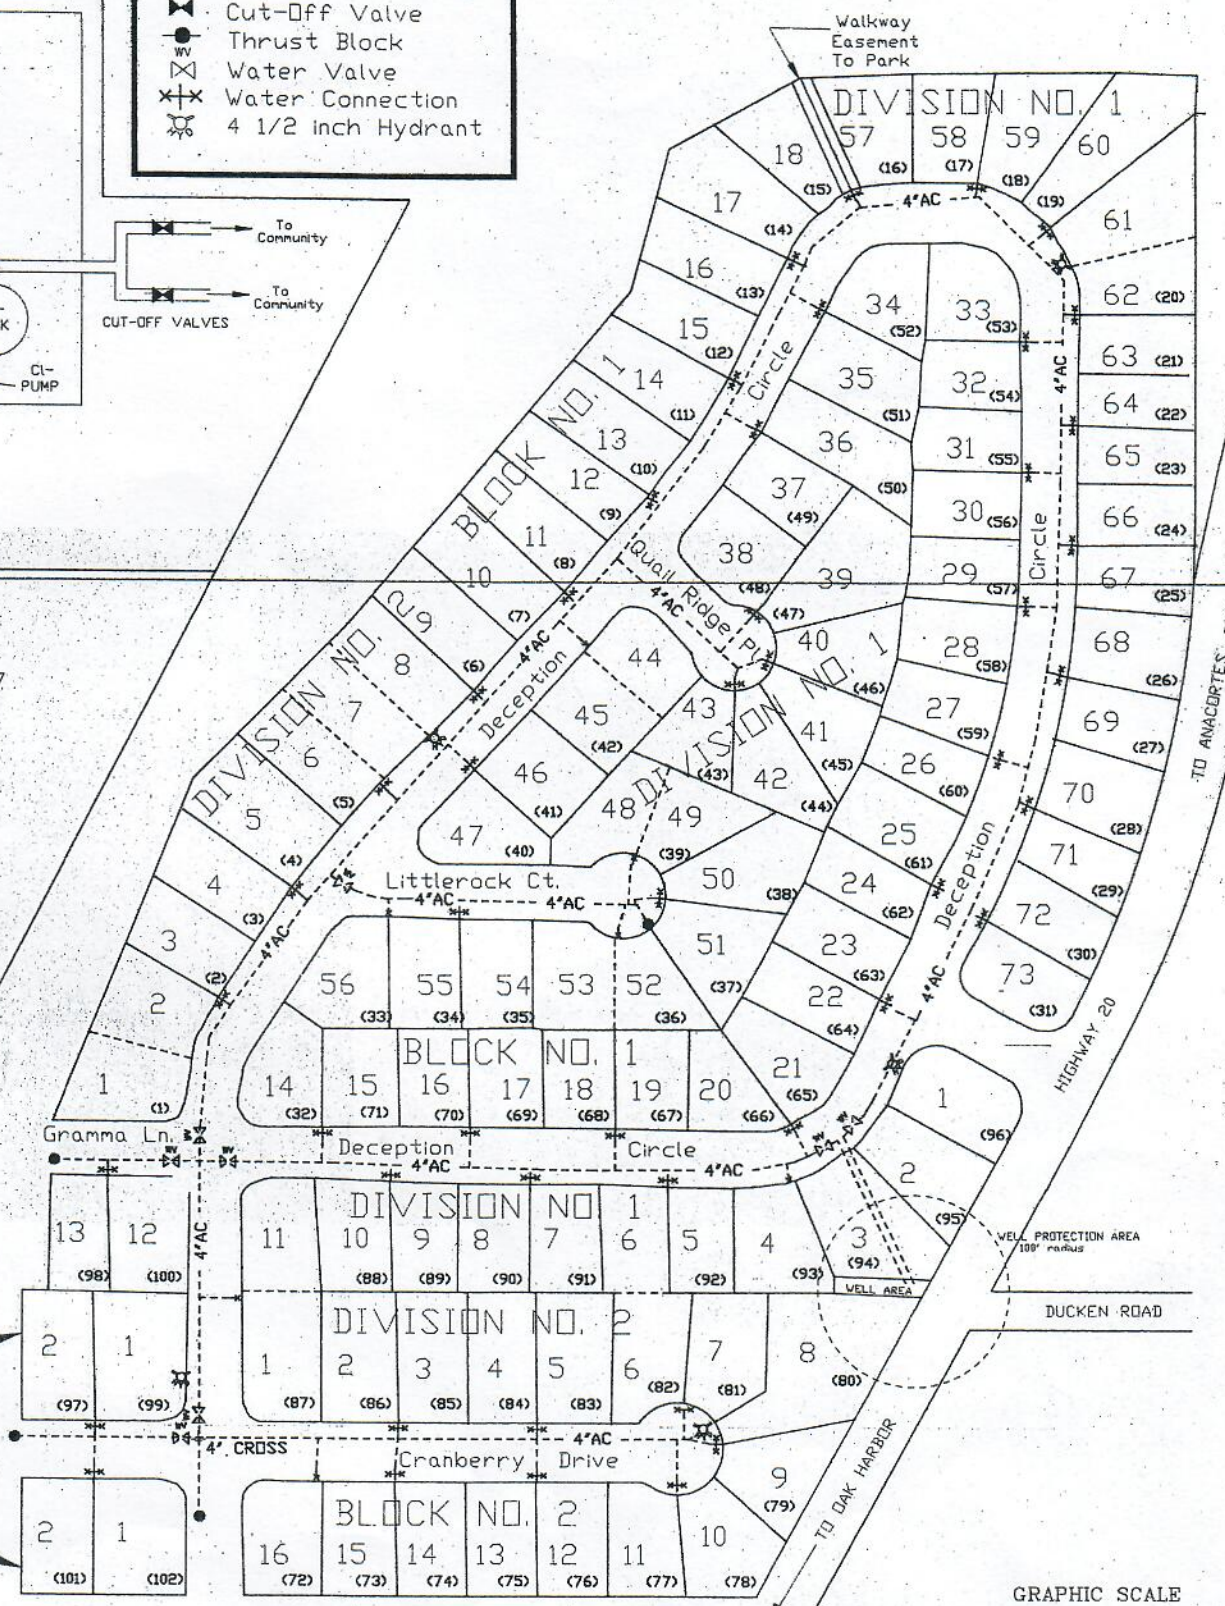

91080d.94  
NAME: DPVASBLT.DWG  
DRAWN BY: RPB  
CHECKED BY: RPB

**DECEPTION PARK VIEW**  
COMMUNITY ASSOCIATION  
Oak Harbor, WA 98277

**WATER WELL AND DISTRIBUTION SYSTEM**  
AS-BUILT DRAWING

DRAWING: DPV  
SHEET: 1 of 6